




THE UNIVERSITY OF
MELBOURNE



Downer EDI Engineering
Electrical Pty. Ltd.
ABN 76007102516
Cliffport Business Centre,
Level 1, 650 Lorimer Street
Port Melbourne VIC 3207
PH. (03) 9644 9100 FAX. (03) 9644 1644

AS-BUILT DRAWING

DATE	REV	AMENDMENT	BY	CHKD
22.01.07	D	FOR CONSTRUCTION PURPOSES -	AC	
04.10.07	H	REVISED TO SUIT ARCHITECTURALS	RAM	KAS
11.12.07	1	SHOP DRAWING		
15.09.08	2	FOR CONSTRUCTION		
09.02.09	3	AS-BUILT DRAWING	DE	MS

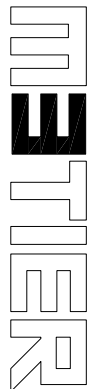

REFERENCE COORDINATION DRAWINGS			
DESCRIPTION	DRAWING NO.	REV	COMO
LEVEL 3 FLOOR PLAN	16.08.07	00/006	02 T0H

Lincolne Scott
Consulting Engineers
248 St Albans Road
St Albans, Victoria 3020
Tel: (03) 9462 7800
Fax: (03) 9462 7801
www.lincolnescott.com.au


Lincolne Scott
Consulting Engineers
248 St Albans Road
St Albans, Victoria 3020
Tel: (03) 9462 7800
Fax: (03) 9462 7801
www.lincolnescott.com.au

PROJECT
UNIVERSITY OF MELBOURNE
ECONOMIC & COMMERCE FACULTY

CLIENT
THE UNIVERSITY OF MELBOURNE

DATE	MAY 2007	DRAWN	SAG
SCALE	1:100	CHECKED	KAS
SHEET SIZE	A1	APPROVED	SBL
CAD FILE			

TITLE		
ELECTRICAL SERVICES		
LEVEL 3		
POWER LAYOUT		
PROJECT NO.	13042	REVISION
	DE - E112	3

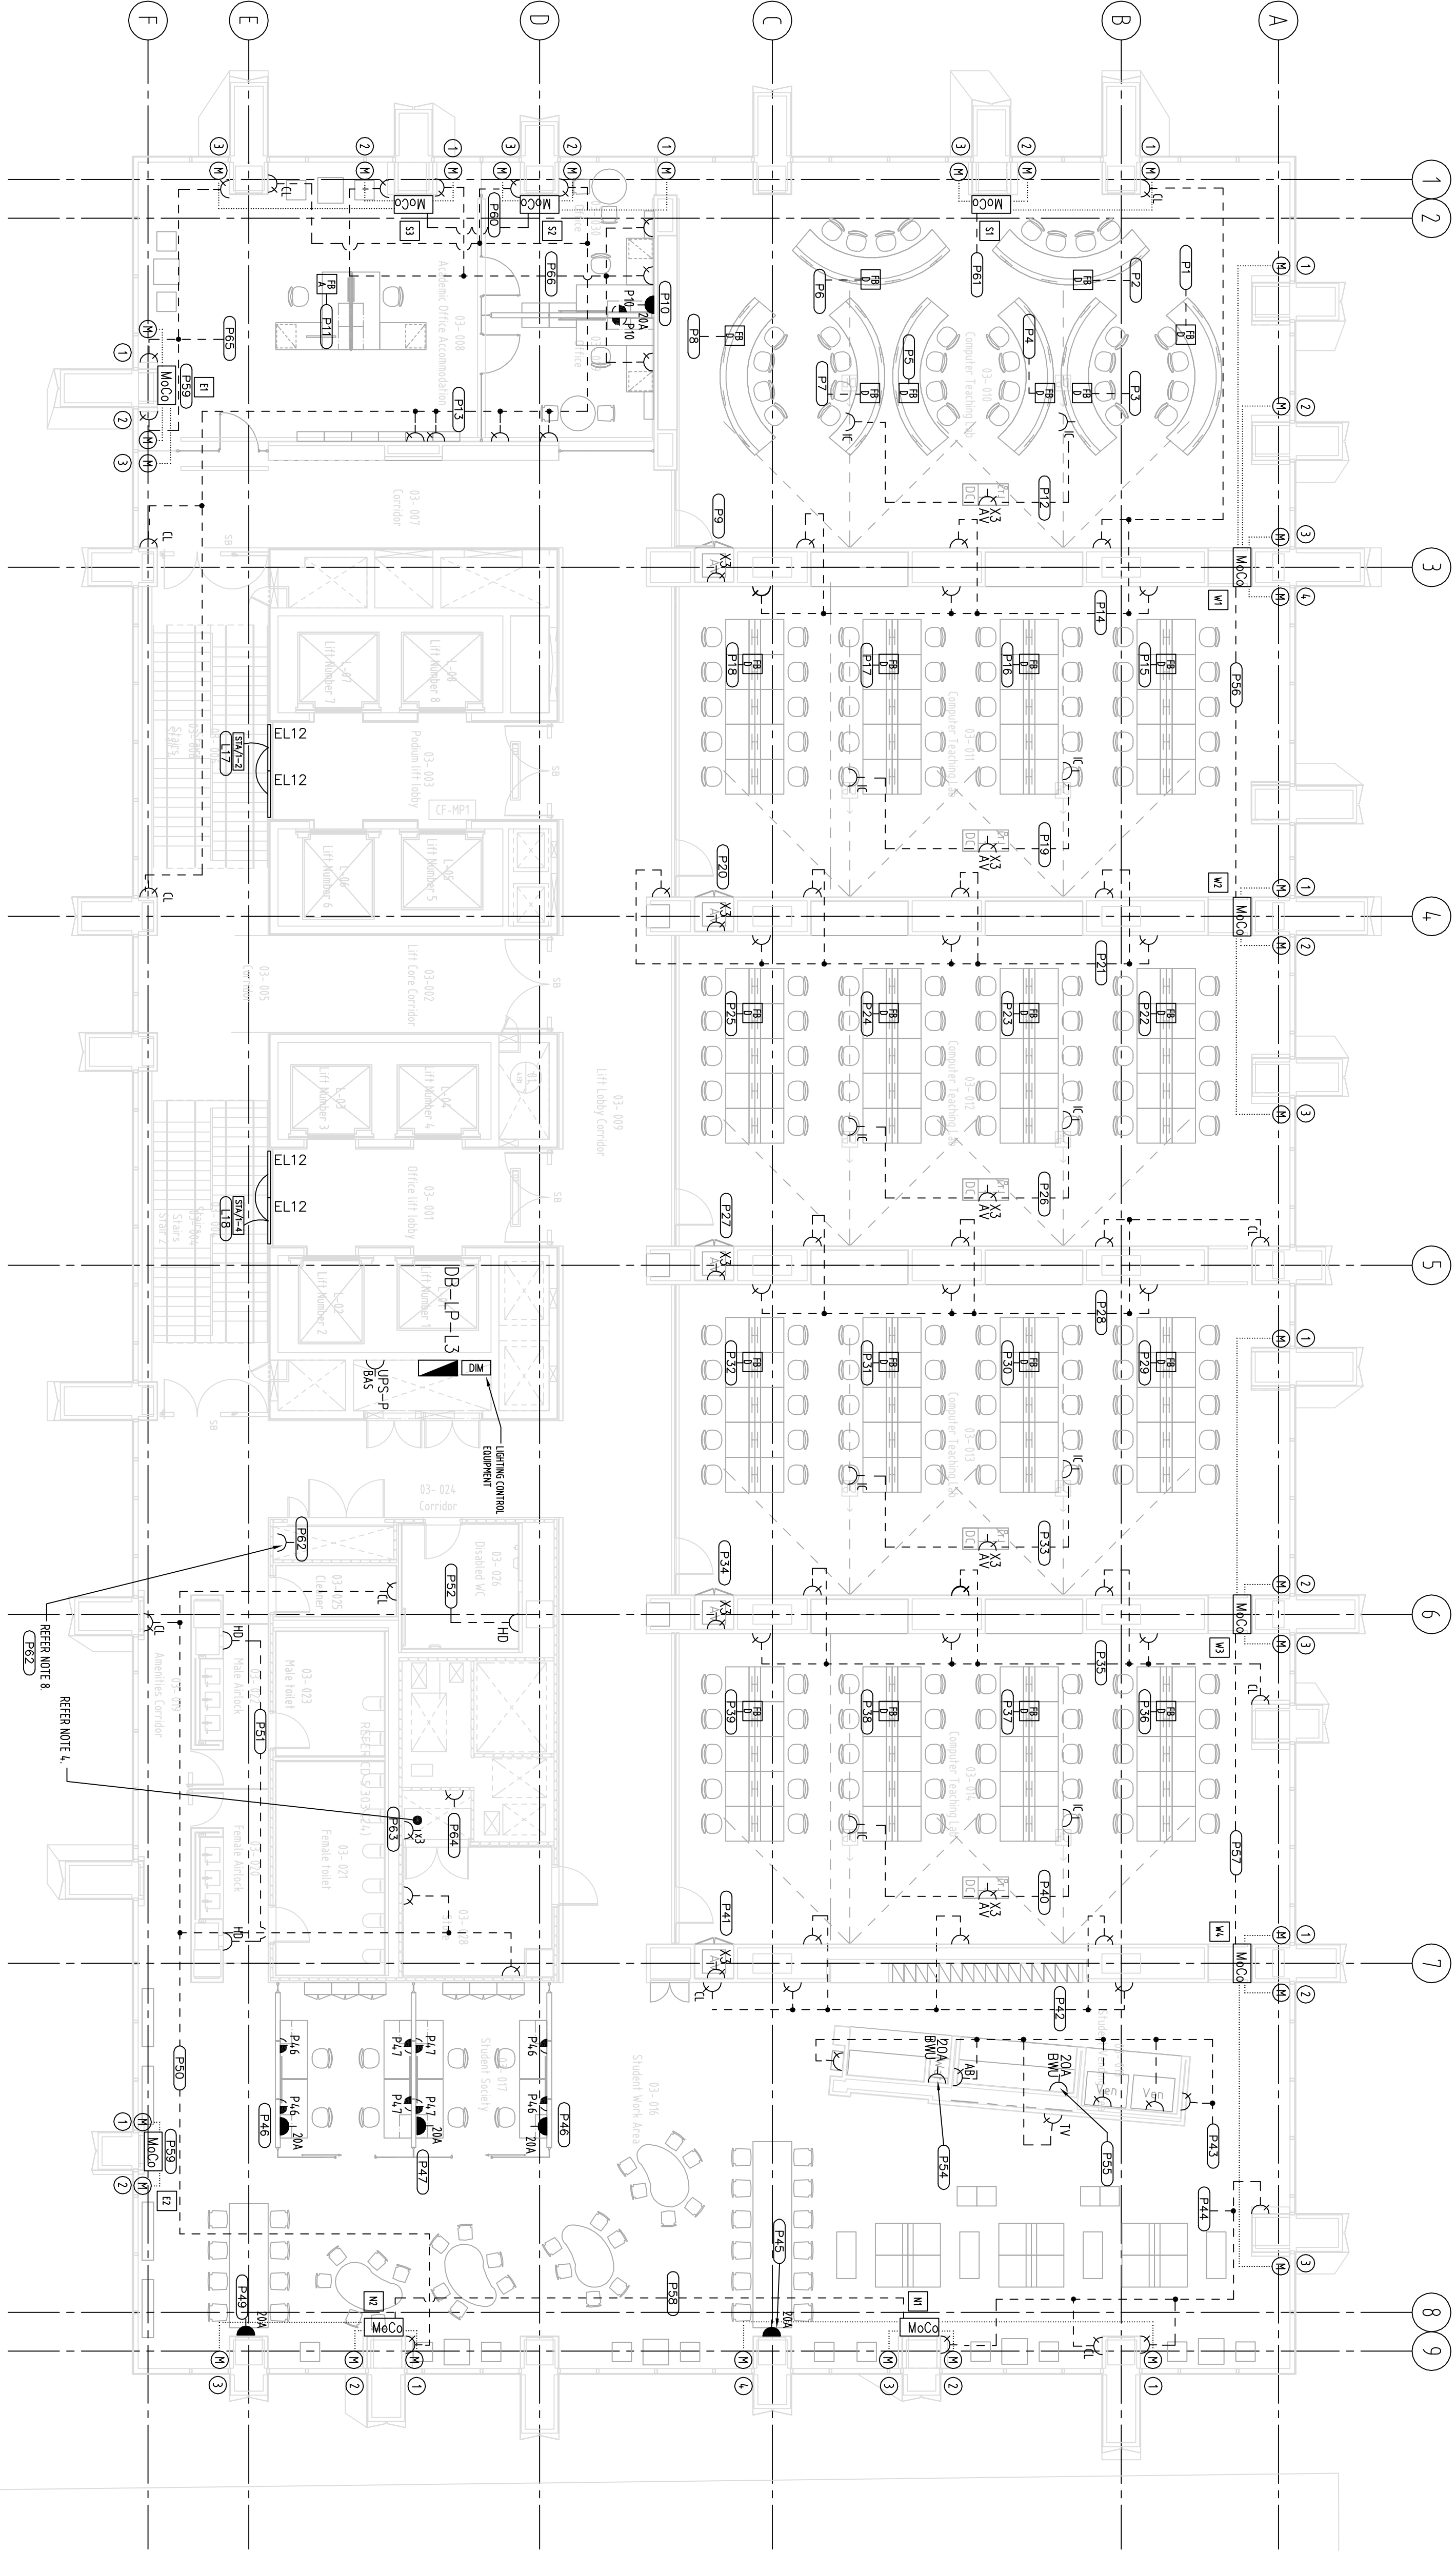

NOTES

1. NOT USED

2. NOT USED

3. NOT USED

4. DEDICATED CIRCUITS FOR SECURITY PANELS & MAYDAY EQUIPMENT.

5. DELETED

6. NOT USED

7. NOT USED

8. ZONE CHECK PUMPS SUPPLIED FROM DB-LP-L3
9. NOT USED

10. NOT USED

11. NOT USED.

12. NOT USED

13. SOFT WARNING OUTLET