




Downer EDI Engineering  
Electrical Pty. Ltd.  
ABN 76007102516  
Citibank Business Centre,  
Level 1, 650 Lormier Street  
Port Melbourne VIC 3207  
Tel. (03) 9644 9100 FAX. (03) 9644 1644

DATE	REV	AMENDMENT	BY	CHKD
06/02/08	1	SHOP DRAWING	DE	MS
08/02/08	2	SHOP DRAWING - LCD POWER AMENED	DE	MS
05/09/08	3	FLOOR CONSTRUCTION	DE	MS
12/02/09	4	AS-BUILT DRAWING	DE	MS

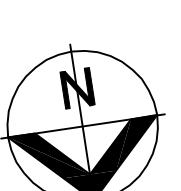

REFERENCE COORDINATION DRAWINGS			
DESCRIPTION	DRAWING NO.	REV	CHNO
LEVEL 5 FLOOR PLAN	CD 008	02	
LEVEL 5 FURNITURE	CD 308	B	
GENERAL FLOOR PLAN	CD 008	G	

# Lincolne Scott

**Consulting Engineers**

Australia Auckland Bangkok  
Brisbane Cairns Canberra  
Honolulu Melbourne Perth  
San Diego Singapore Sydney


Level 5 Midtown Tower  
246 Bourke Street Melbourne  
Victoria 3000 Australia  
Telephone 61 3 8663 7800  
Facsimile 61 3 8663 7800

PROJECT  
UNIVERSITY OF MELBOURNE  
ECONOMIC & COMMERCE FACULTY


[illegible]

DATE	MAY 2007	DRAWN	SAG
SCALE	1:100	CHECKED	KAS
SHEET SIZE	A1	APPROVED	SBL
CAD FILE	E110.DWG		

PROJECT NO	DRAWING NO	REVISION
1	OVER	END

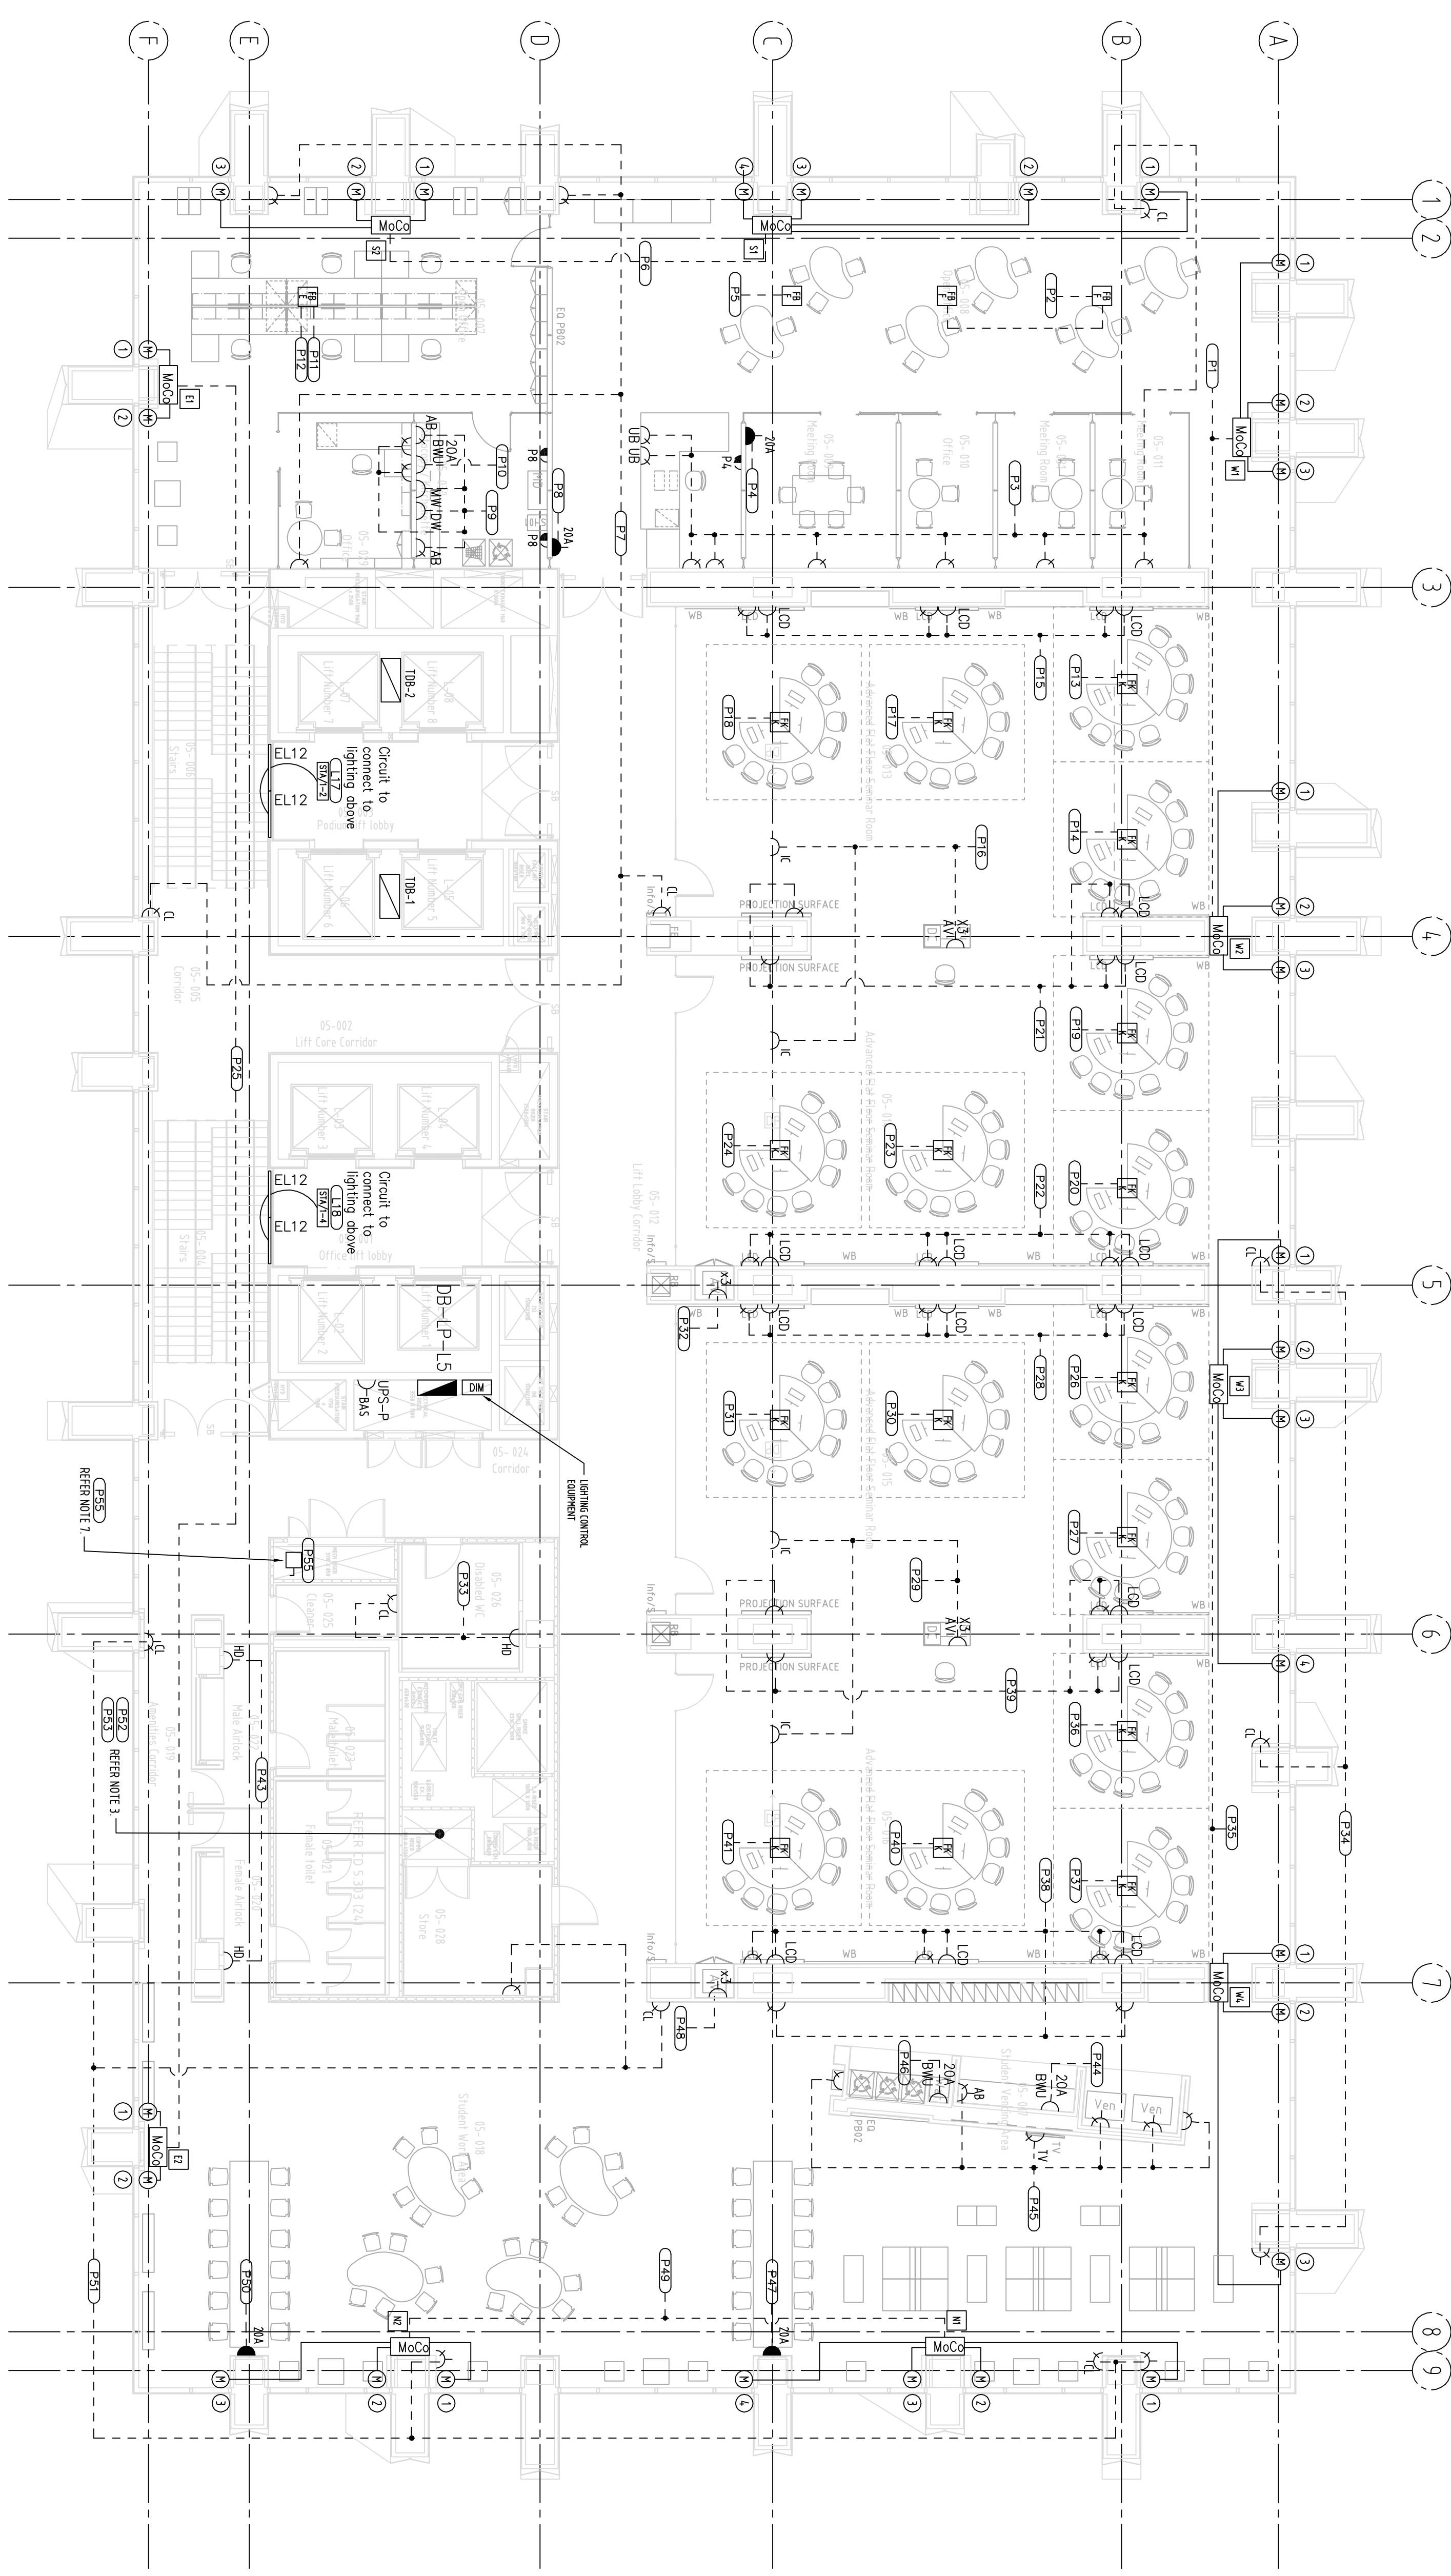

1 NOT USED

1. NOT USED
2. NOT USED
3. DEDICATED CIRCUITS FOR SECURITY PANELS & MAIN EQUIPMENT.
4. DELETED.
5. NOT USED
6. NOT USED
7. ZONE CHECK PUMPS SUPPLIED FROM DB-LP-1
8. NOT USED
9. NOT USED
10. NOT USED
11. NOT USED
12. NOT USED
13. NOT USED.
14. NOT USED
15.  SOFT WIRING OUTLET

P55