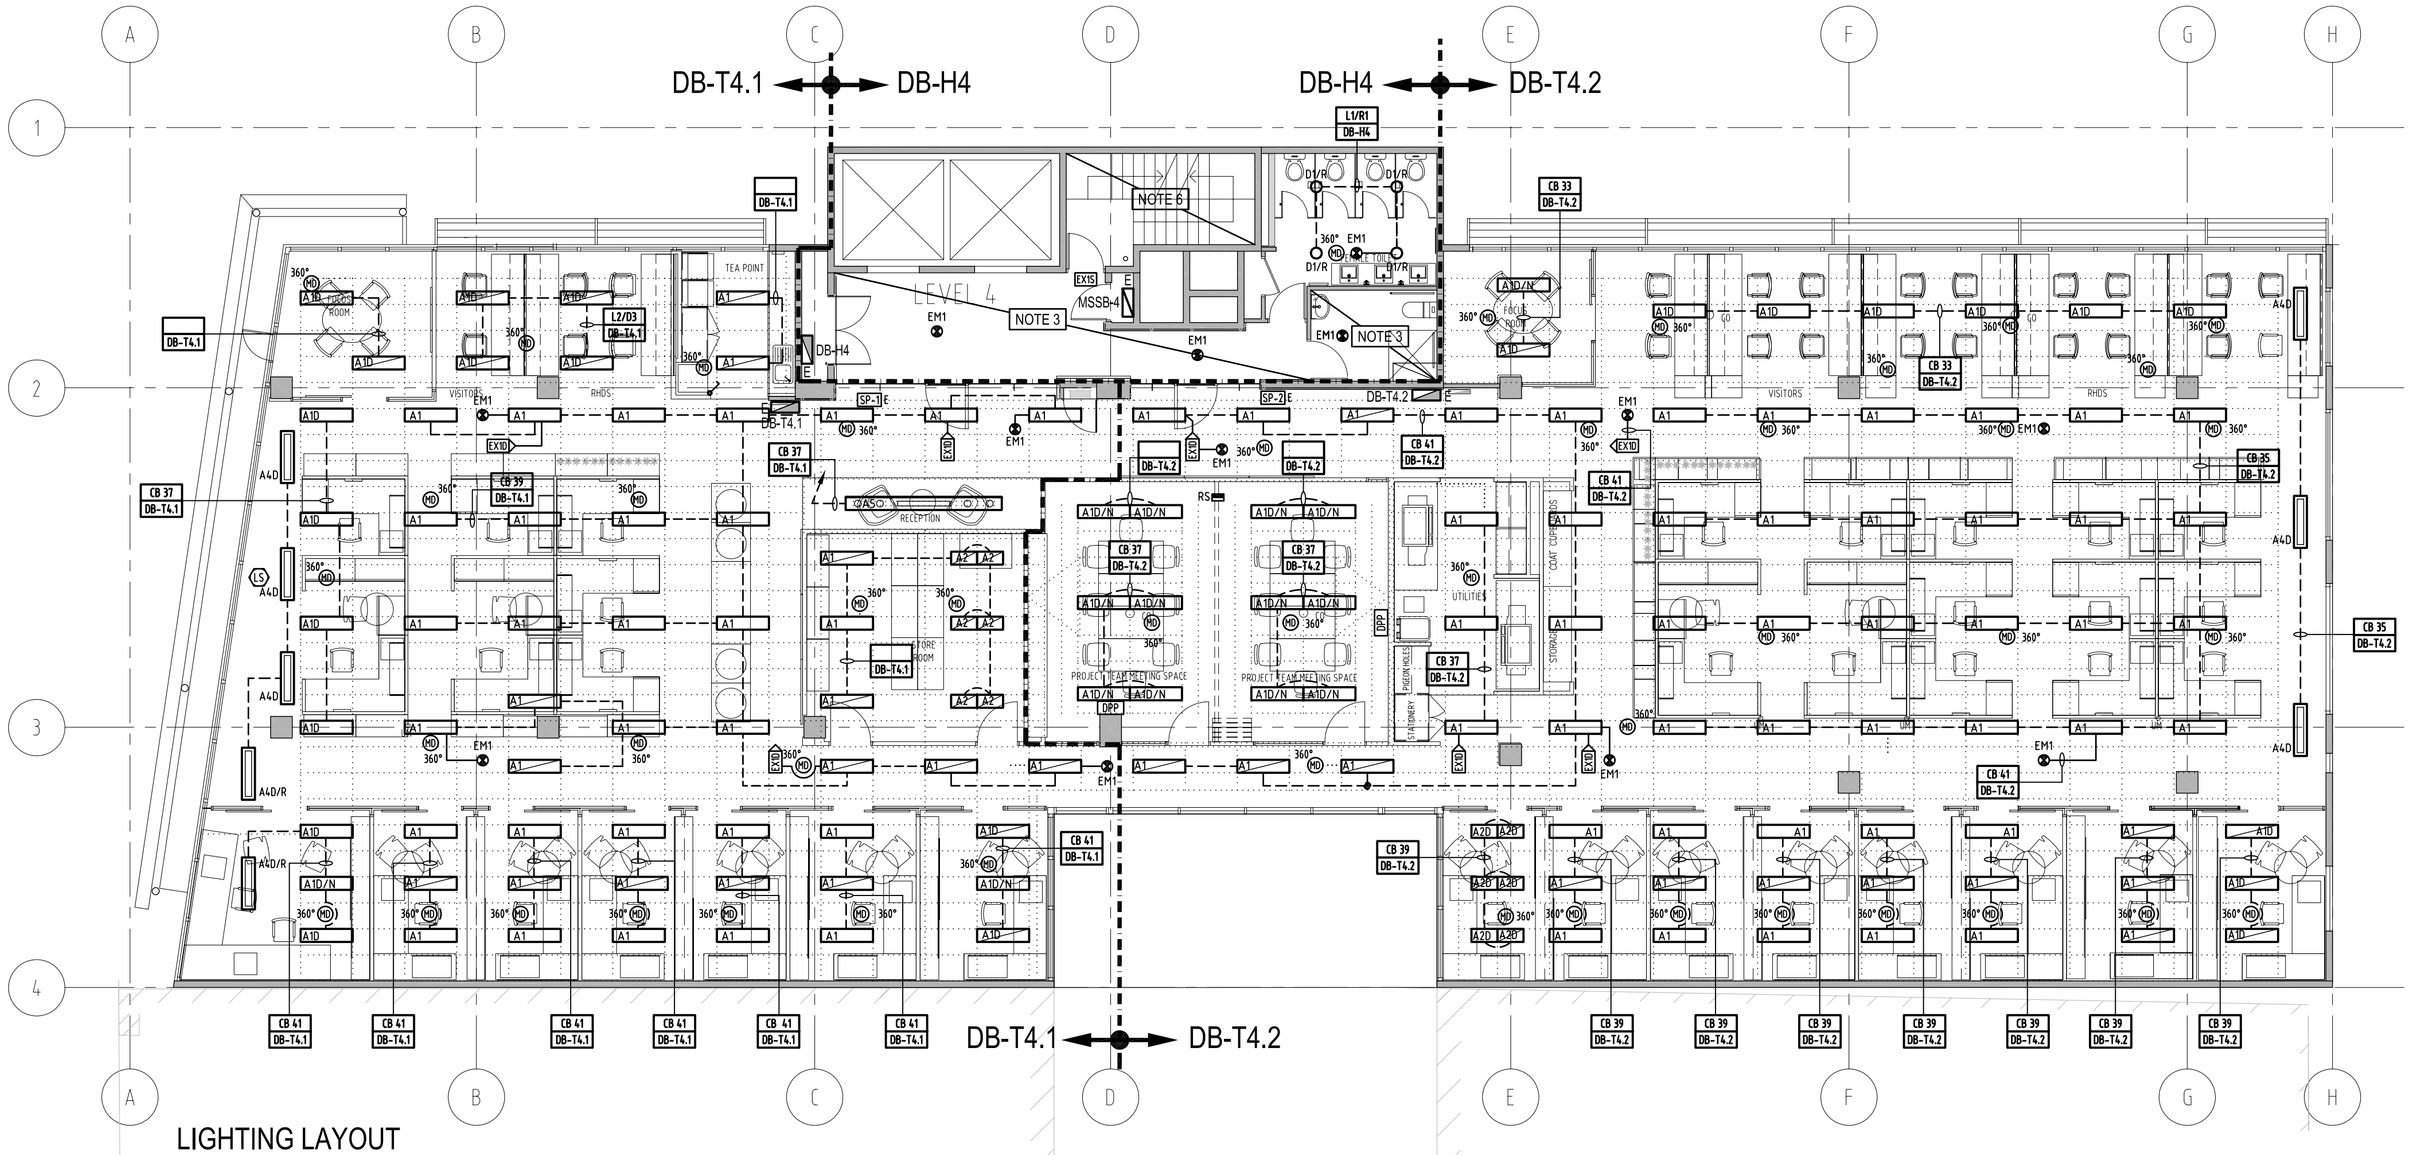

LIGHTING LAYOUT

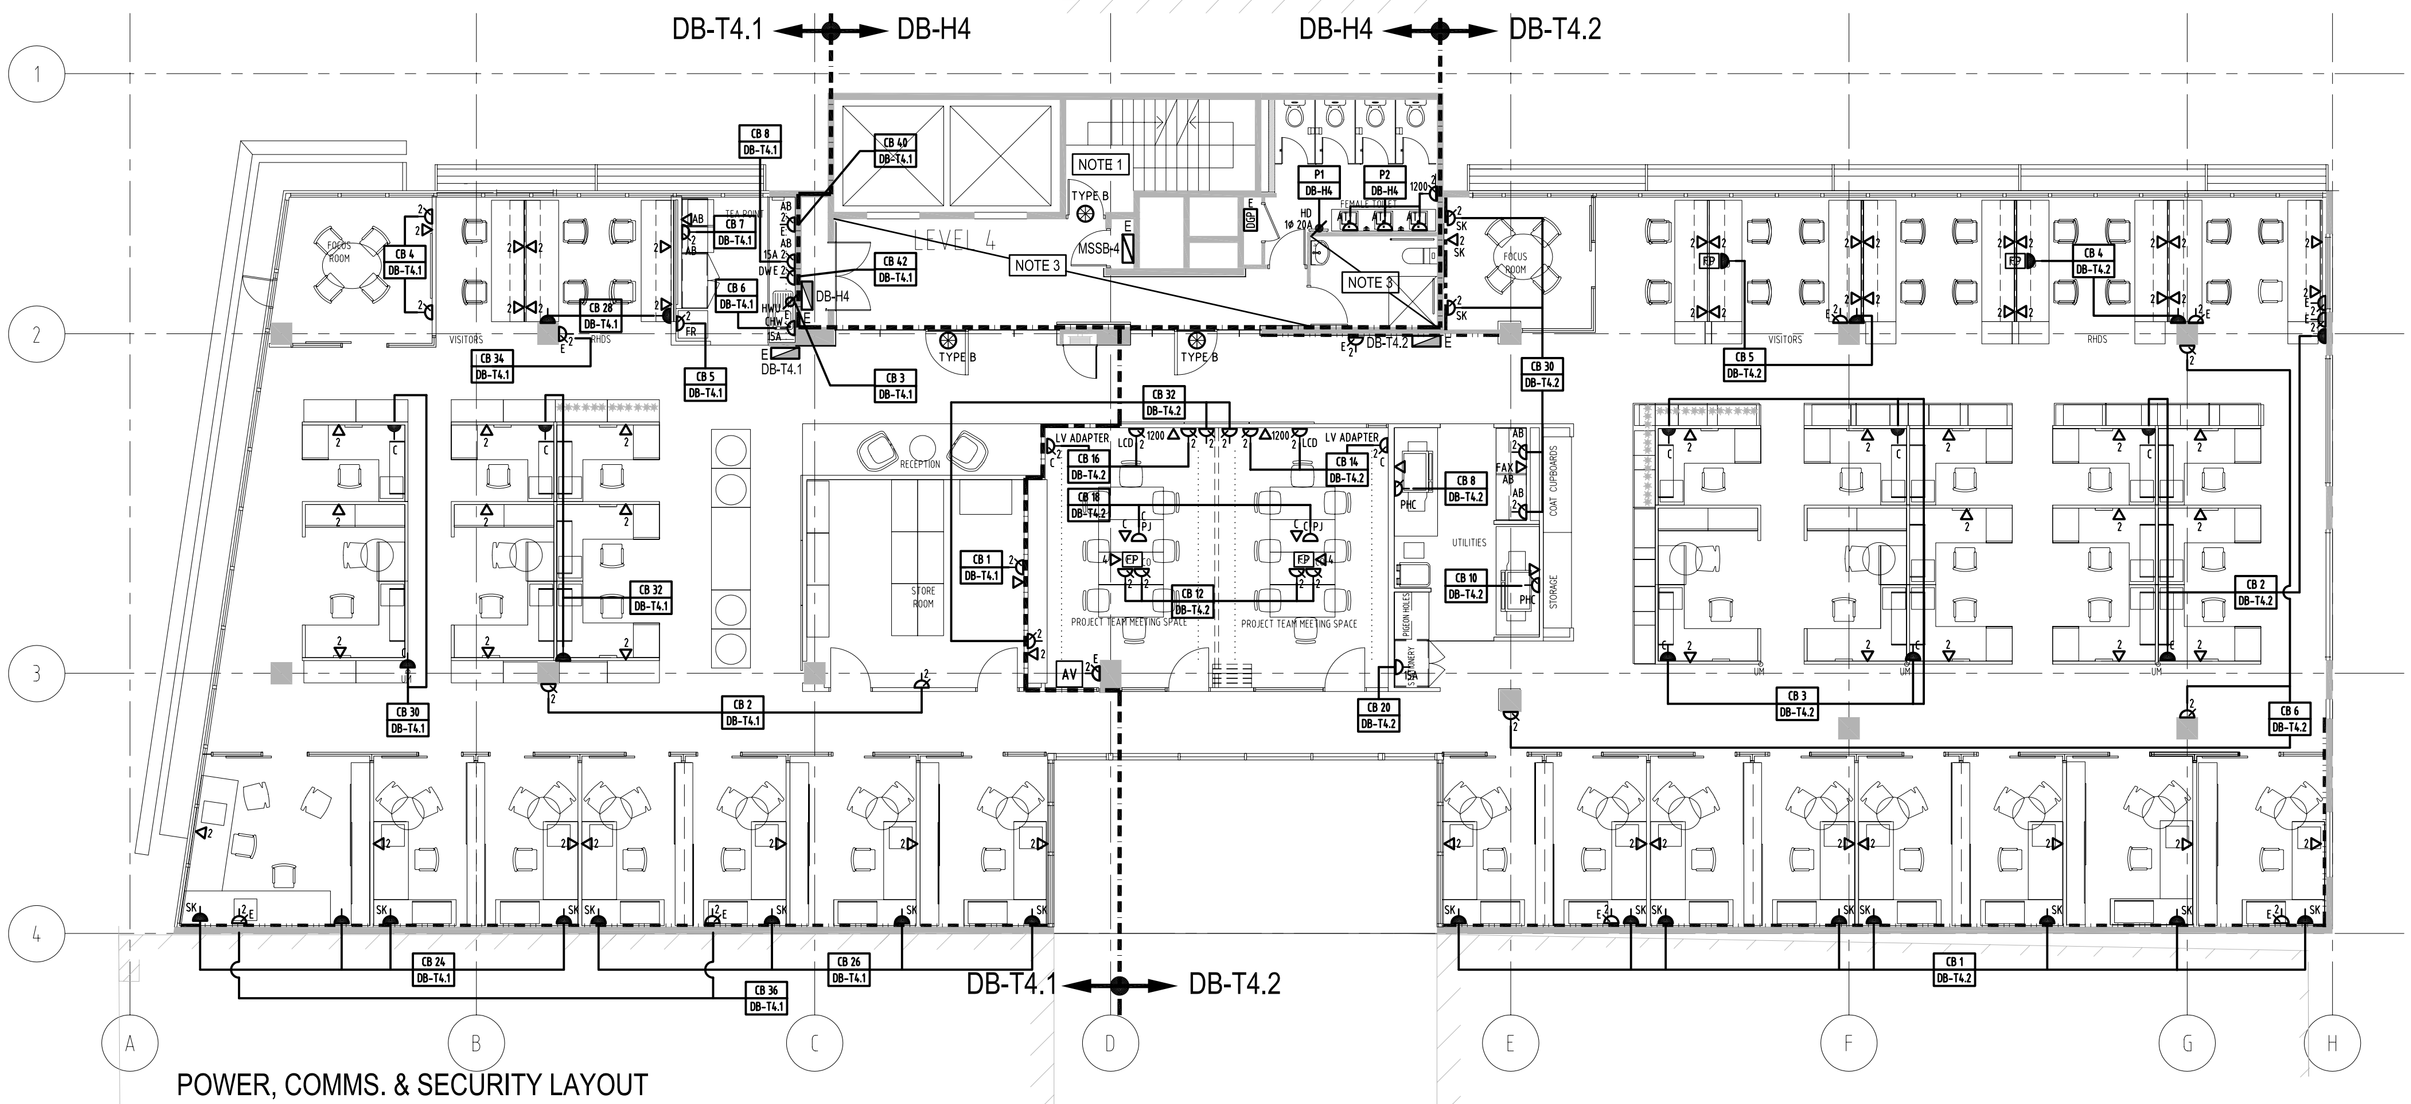

POWER, COMMS. & SECURITY LAYOUT

REV	DESCRIPTION	BY	DATE

STATUS

AS BUILT DRAWING

0 1 2 4 6

SCALE (m) 1:100

Downer

Downer EDI Engineering
Electrical Pty. Ltd.
ABN 76 007 102 516
Citiport Business Centre,
Level 1, 650 Lorimer Street
Port Melbourne VIC 3207
PH. (03) 9644 9100 FAX. (03) 9645 1644

PROJECT

MELBOURNE GRADUATE SCHOOL OF EDUCATION

100 LEICESTER STREET

CLIENT

UNIVERSITY OF MELBOURNE

TITLE

ELECTRICAL SERVICES
LEVEL FOUR
LIGHTING & POWER LAYOUT

NORTH

DESIGNED	DRAWN	APPROVED	SCALE @ A1
JS	LLN	CH	1:100

PROJECT No	DRAWING No	REV
104239	DE 1104	

DWG FILE: Z:\ - 2011 PROJECTS - 110110\downer - 104239E1104.dwg - MH PLOT TIME: 05 Jul 2011, 9:13am